


SEC. 14, TWP. 24, N RNG. 1 E, WM
KITSAP COUNTY, WASHINGTON

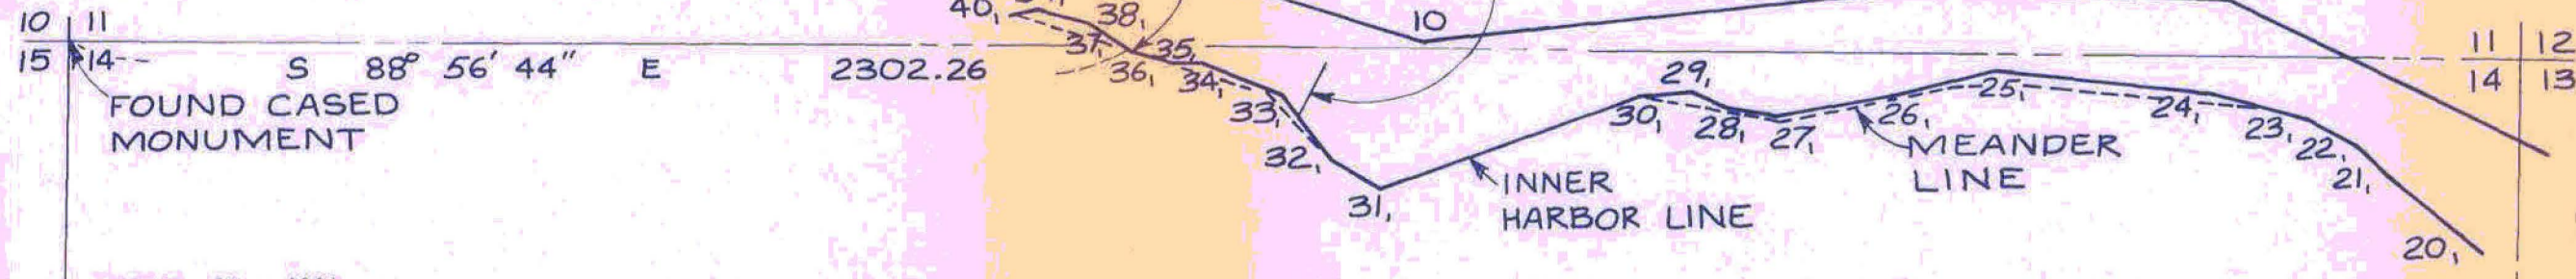

SCALE: 1" = 400'

CONVERSION TABLE	CITY	P.S.N.S.
Extreme High Water (EHW)	125.15	124.8
Mean Higher High Water (MHHW)	121.45	121.1
Mean High Water (MHW)	120.55	120.2
Mean Tide Level (MTL)	116.55	116.2
Mean Lower Low Water (MLLW)	109.75	109.4
Extreme Low Water (ELW)	105.35	105.0

VERTICAL DATUM: City of Bremerton (the relationships between the City of Bremerton Datum, and the Puget Sound Naval Shipyard Datum are shown below.)

BASIS OF BEARING: Washington State Plane Coordinate System, North Zone

REFERENCED:

- State of Washington Board of State Land Commissioners, Maps of Bremerton Tide lands showing Harbor Lines and Tide Lands as Surveyed Established and Platted by order of the Board of State Land Commissioners. And filed in the Office of the Commissioner of Public Lands on the 28th day of February A.D. 1913.
- Right of Way Plat, Cascade Natural Gas Co. Section II and 14, TWP. 24N., RGE. 1E., W.M. Kitsap County, Washington. This Plat was done by Jones and Associates on the 6th day of November 1974.



Description of Lease of Publicly Owned Aquatic Lands

A strip of land 15 feet in width, 7.5 feet left and right of the following described centerline, situated in Section 14, Township 24 North, Range 1 East, Willamette Meridian, Kitsap County, Washington:

Commencing at the Northwest corner of said Section 14; thence South 85° 42' 21" East 2661.81 feet to a point on the Meander Line per State of Washington Board of State Land Commissioners, Maps of Bremerton Tide Lands 28 February 1913 (Page 5); said point being the True Point of Beginning; thence North 28° 36' 45" East 13.61 feet to a point on the Inner Harbor Line, said point being South 85° 58' 19" East 2667.48 feet from the Northwest corner of Section 14; thence North 28° 36' 45" East 147.20 feet to the Terminus Point of said strip.

The described strip contains 0.06 acres.

FROM THE LEASE JACKETS OF:
AQUATIC RESOURCES-DNR
POSSIBLE UNOFFICIAL MODIFICATIONS
MAY EXIST. CHECK ORIGINAL MAP FOR
VERIFICATION.

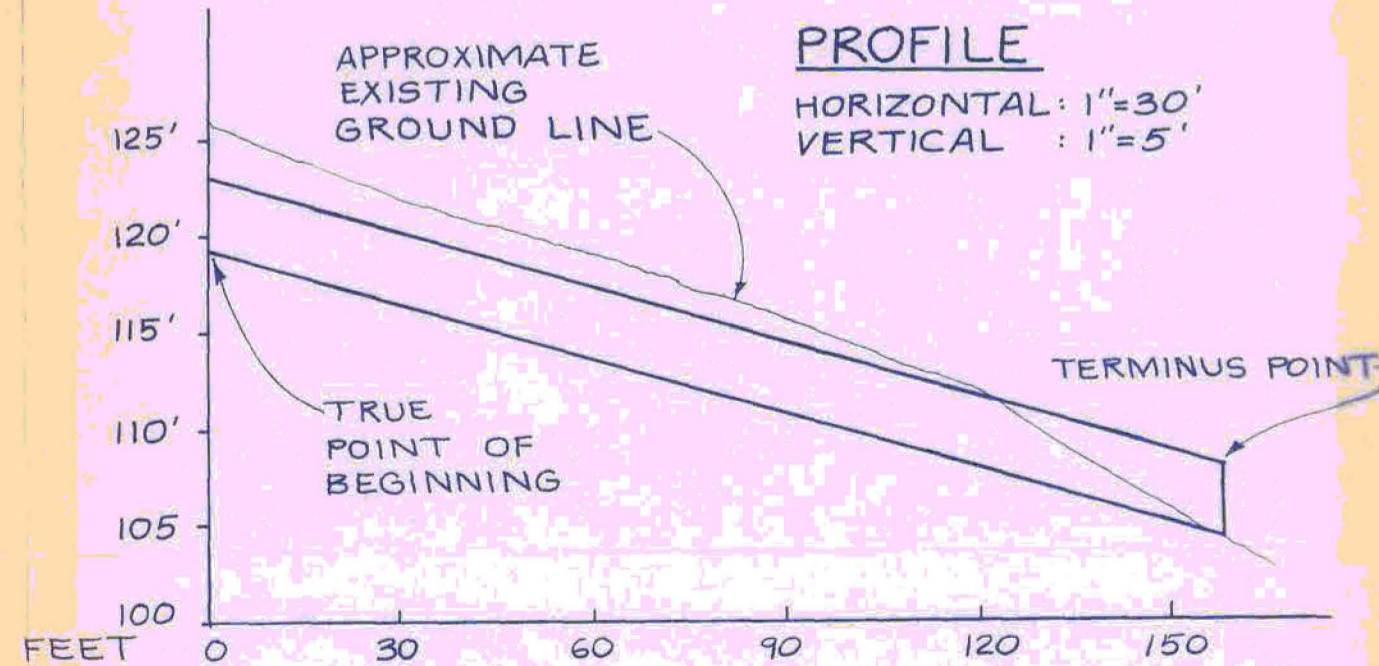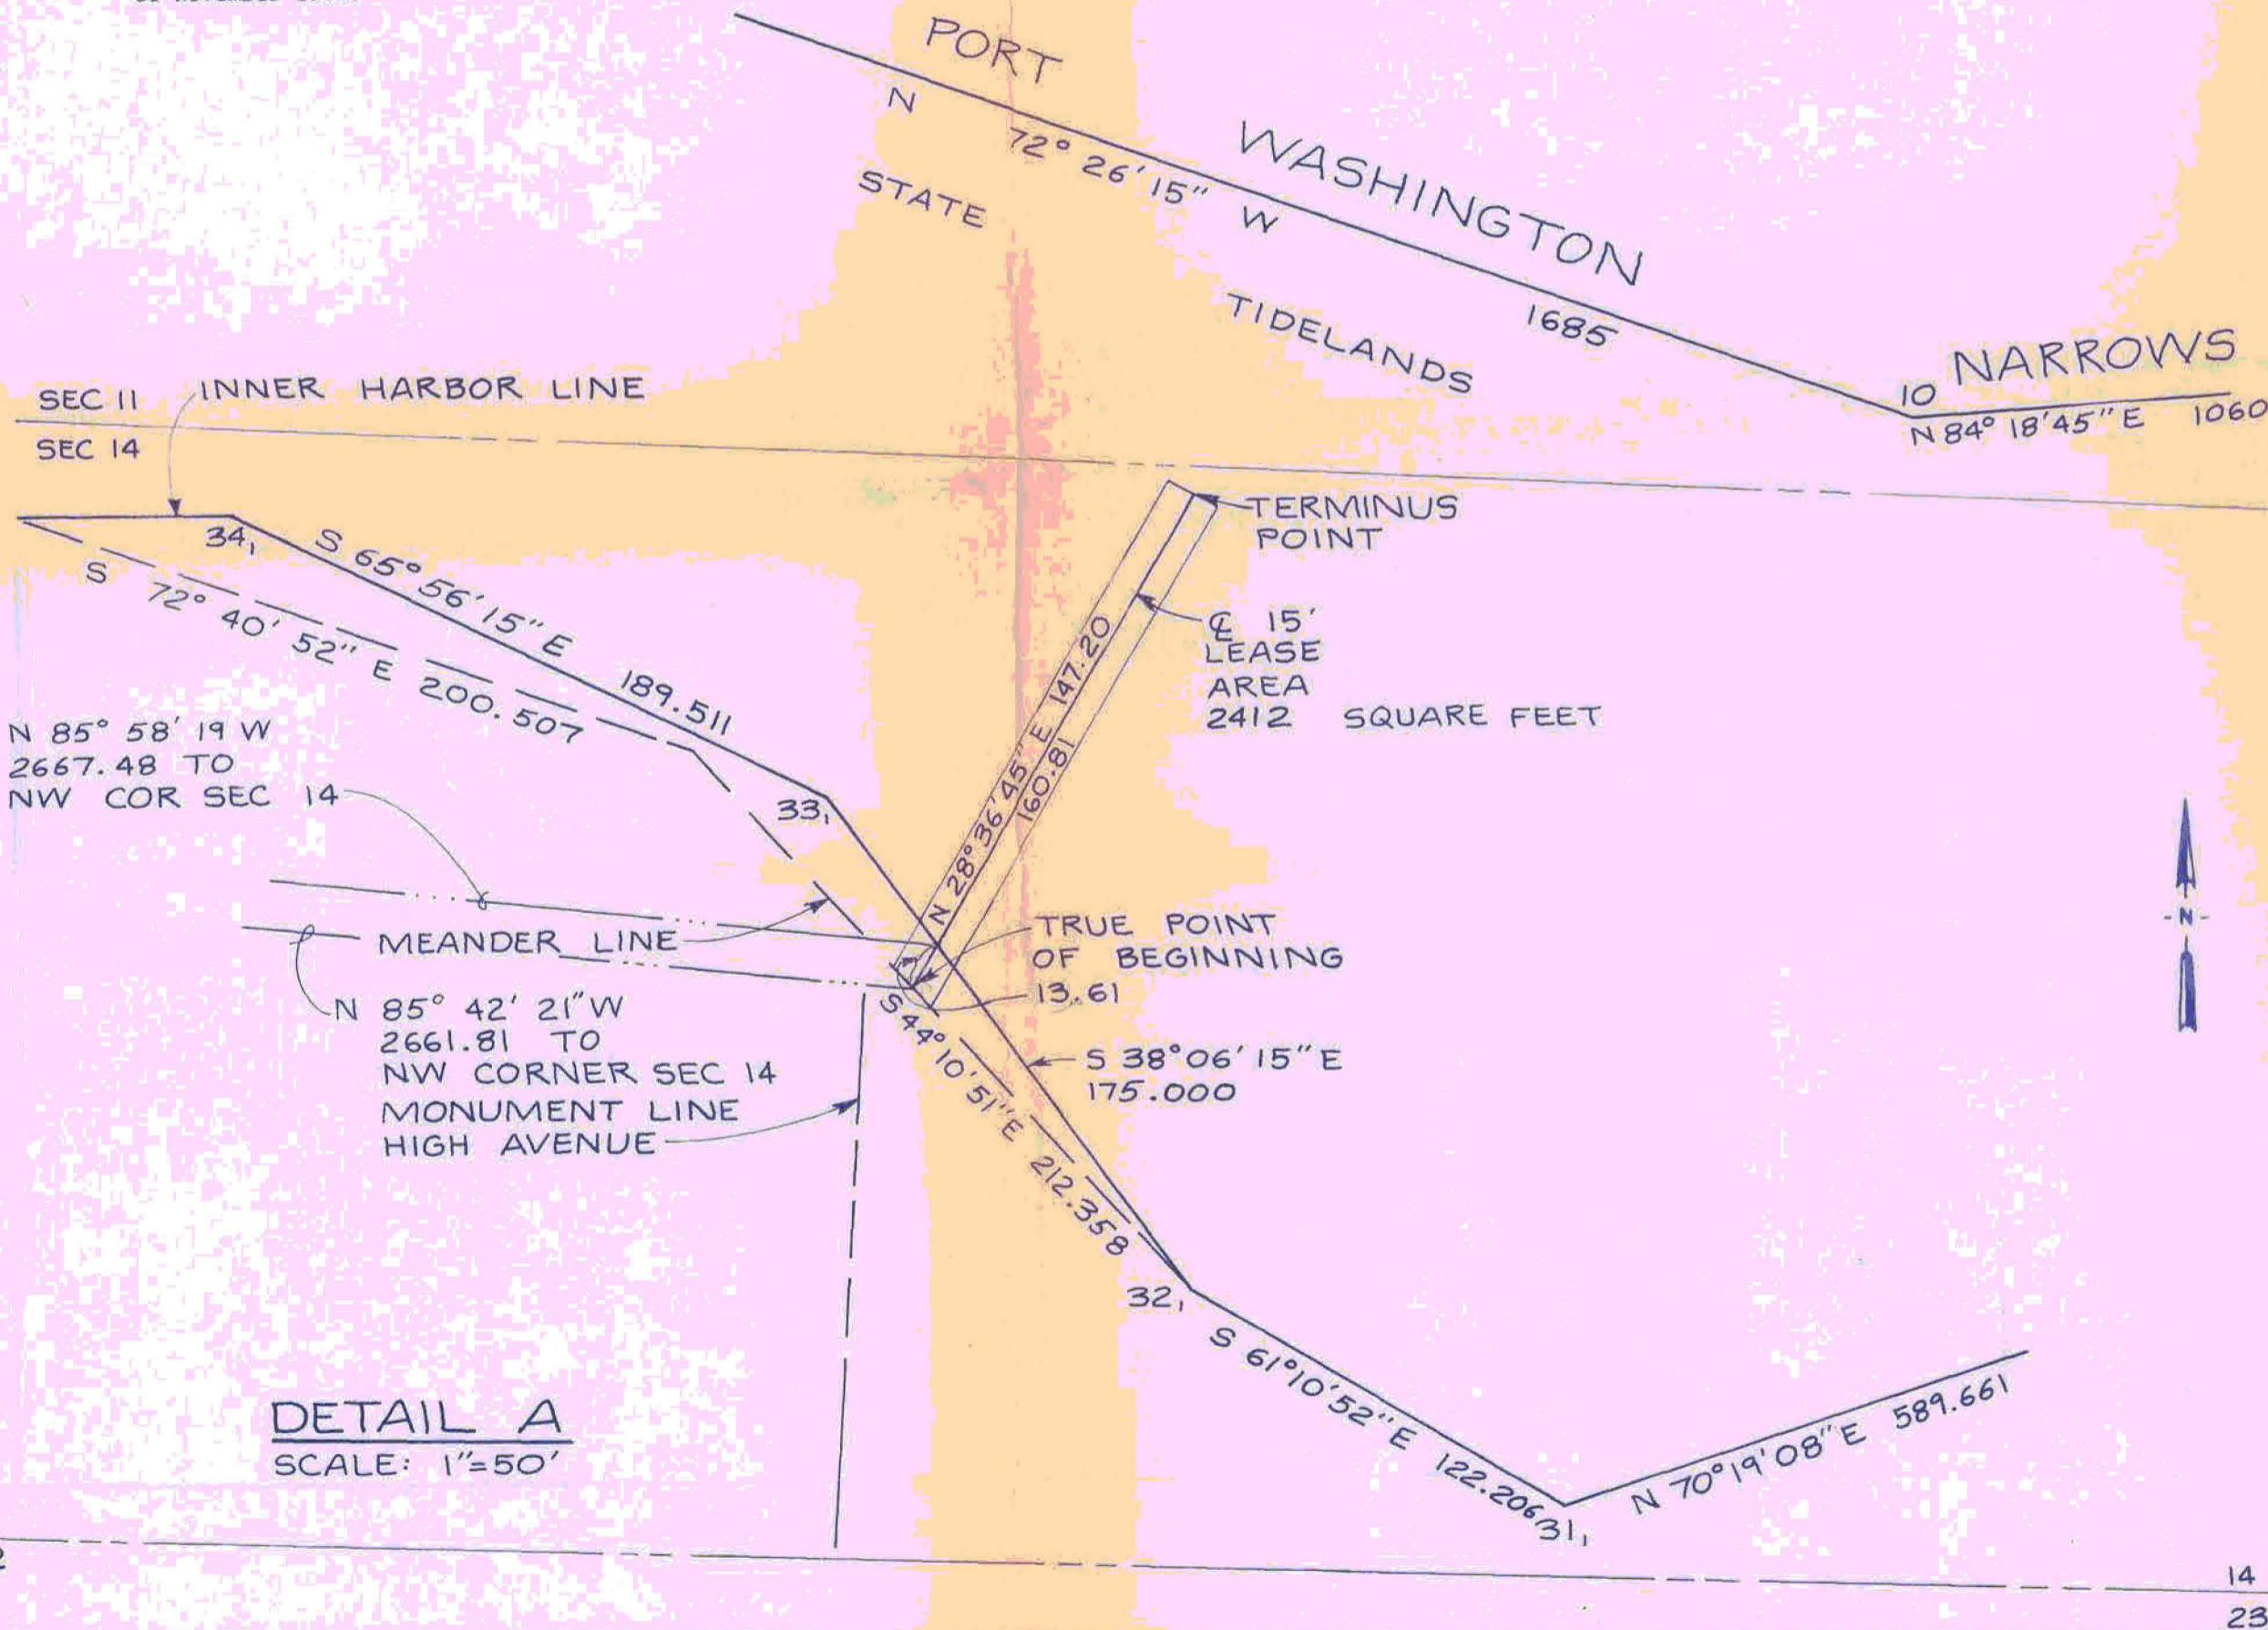

CH2M HILL

DRAWN BY: WJM
CHECKED BY: JLC
JOB NO. S 12400.D6
DATE: 9-26-83
SCALE: 1"=400'
SHEET 1 OF 1

RECORDER'S CERTIFICATE

Filed for record this _____ day of _____, 19____ at _____ M. in Book _____ of Surveys at page _____ at the request of _____

Manager _____ Superintendent of Records _____

51-045730 - AQ

SURVEYOR'S CERTIFICATE



This map correctly represents a survey made by me or under my direction in conformance with the requirements of the Survey Recording Act at the request of CITY OF BREMEROTN in SEPTEMBER, 1983.

Jerry G. Morris
Certificate No. 17673

RECORD SURVEY
For
CITY OF BREMEROTN
DNR LEASE
HIGH AVE. OUTFALL